PLATE 38

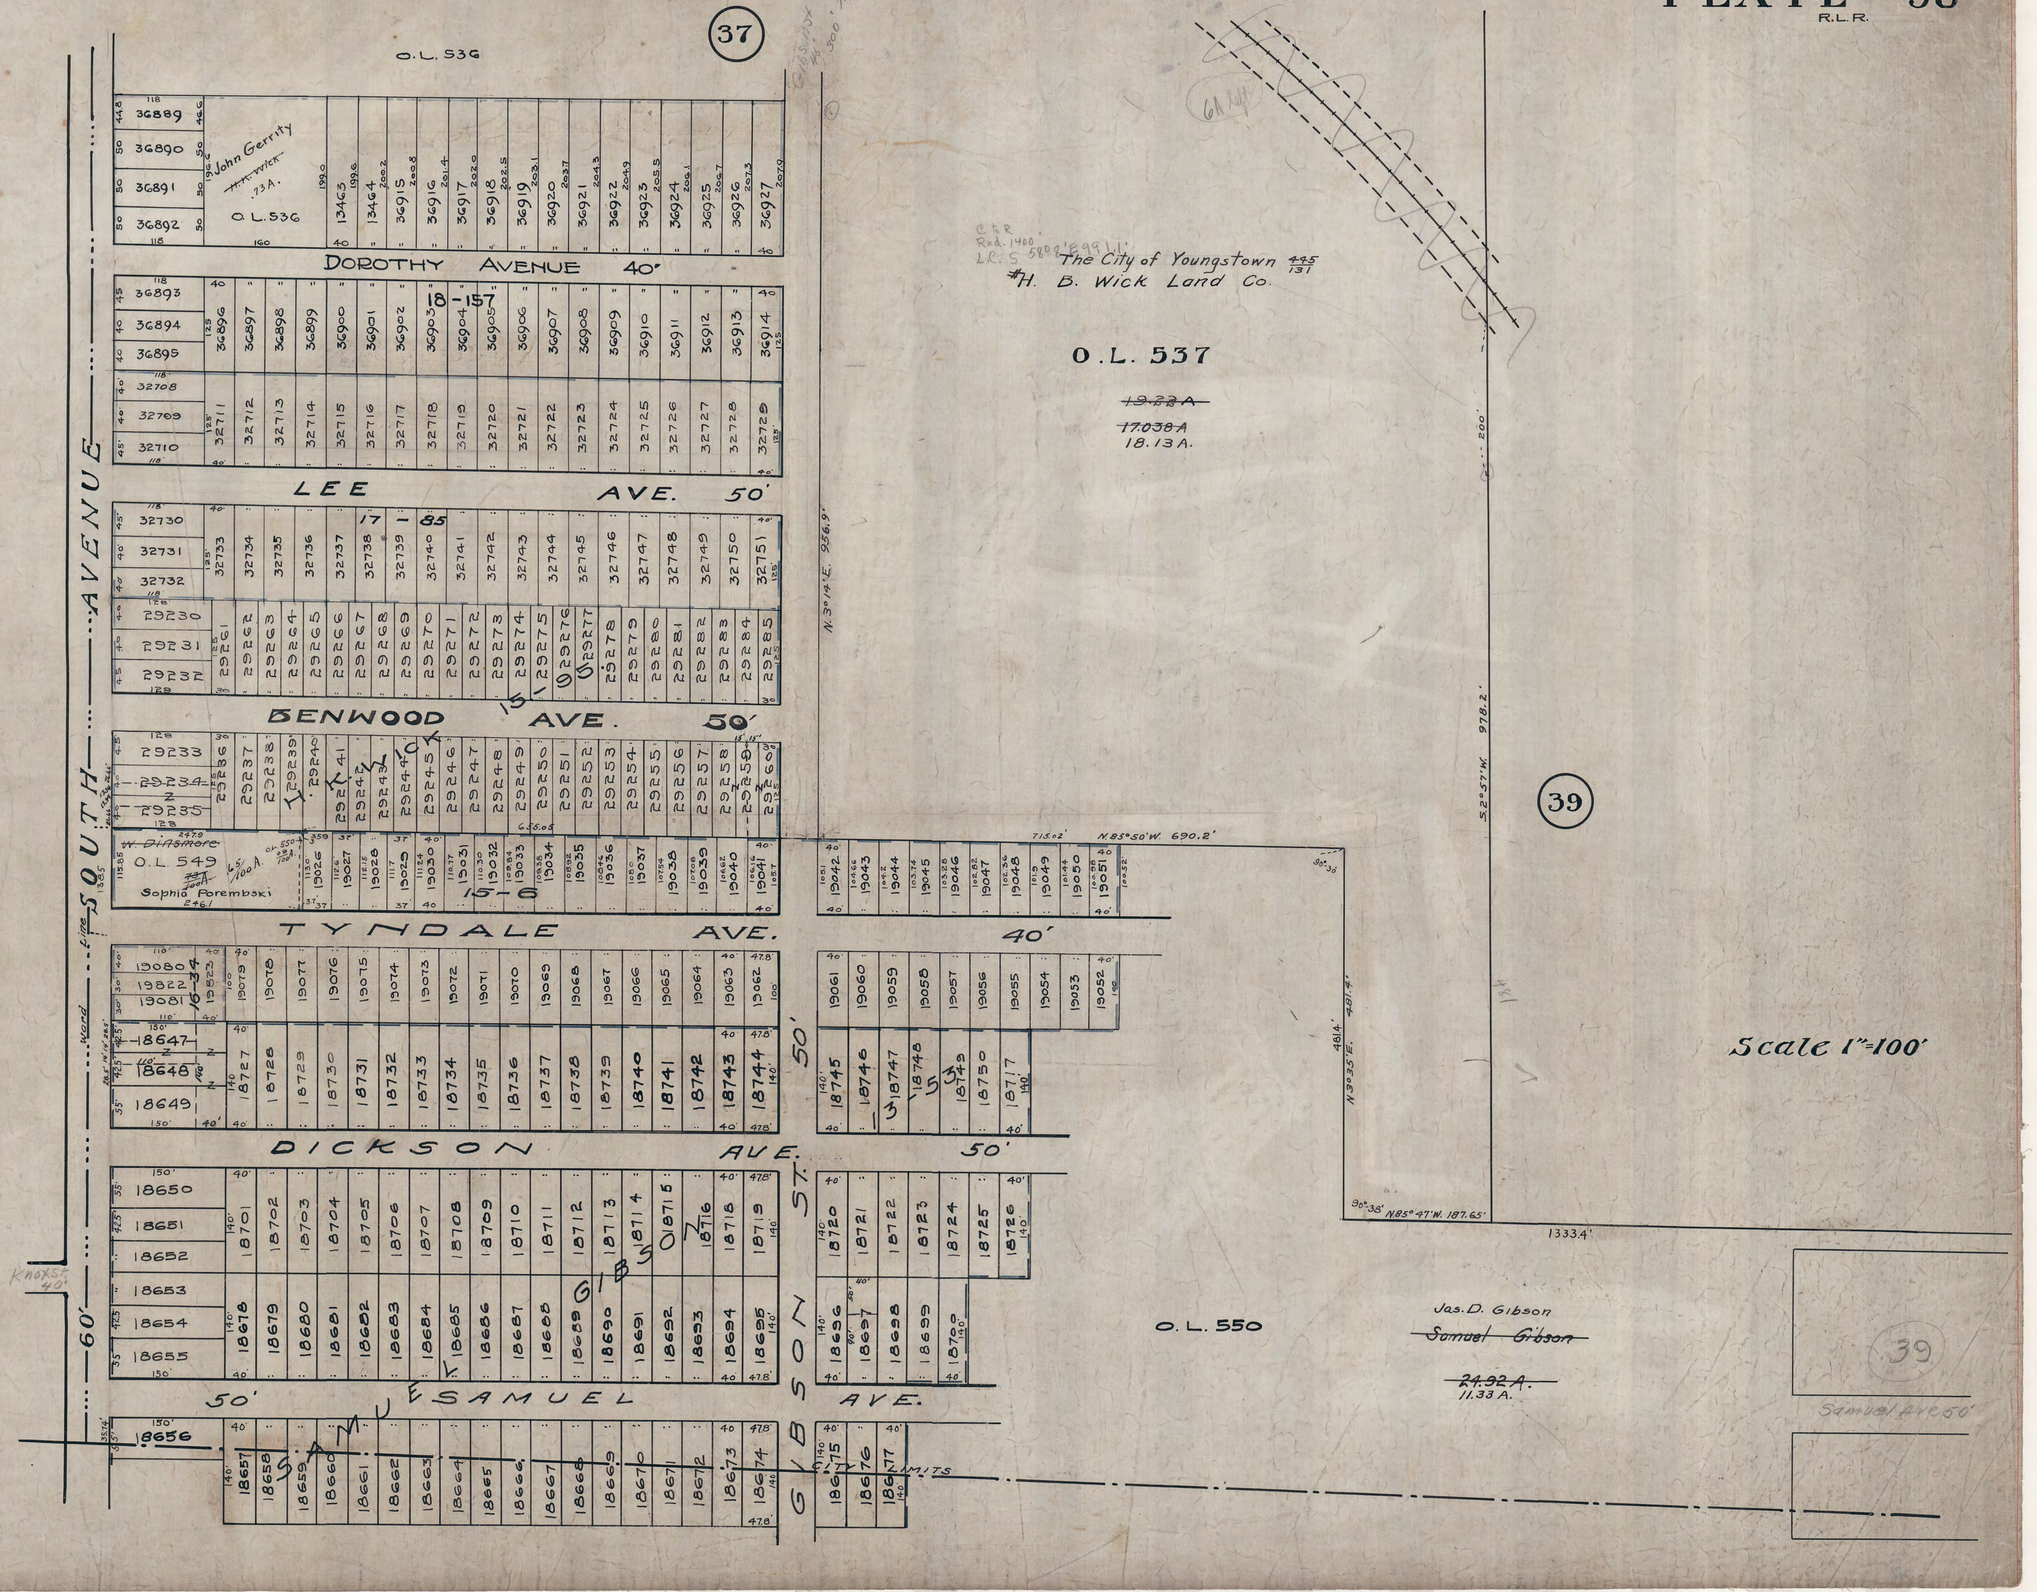
R.L.R.
37
O.L. 536
DOROTHY AVENUE 40'
LEE AVE. 50'
BENWOOD AVE. 50'
TYNDALE AVE. 40'
DICKSON AVE. 50'
SAMUEL AVE. 50'
SOUTH AVENUE
GIBSON ST.
Knox St. 40'
60'
Ward Line
John Gerrity
H.K. Wick
.73A.
O.L. 536
18-157
17-85
15-6
15-1
15-3
W. Dinsmore
O.L. 549
Sophia Porembski
H.K. Wick
GIBSON
SAMUEL
CITY LIMITS
The City of Youngstown 445/131
#H. B. Wick Land Co.
O.L. 537
~~19.23A~~
~~17.038A~~
18.13A.
39
Scale 1"=100'
O.L. 550
Jas. D. Gibson
~~Samuel Gibson~~
~~24.92A.~~
11.33A.
Samuel Ave. 50'
N.3°14'E. 956.9'
S.2°57'W. 978.2'
N.85°50'W. 690.2'
N.85°47'W. 187.65'
1333.4'
N.3°35'E. 481.4'
48